
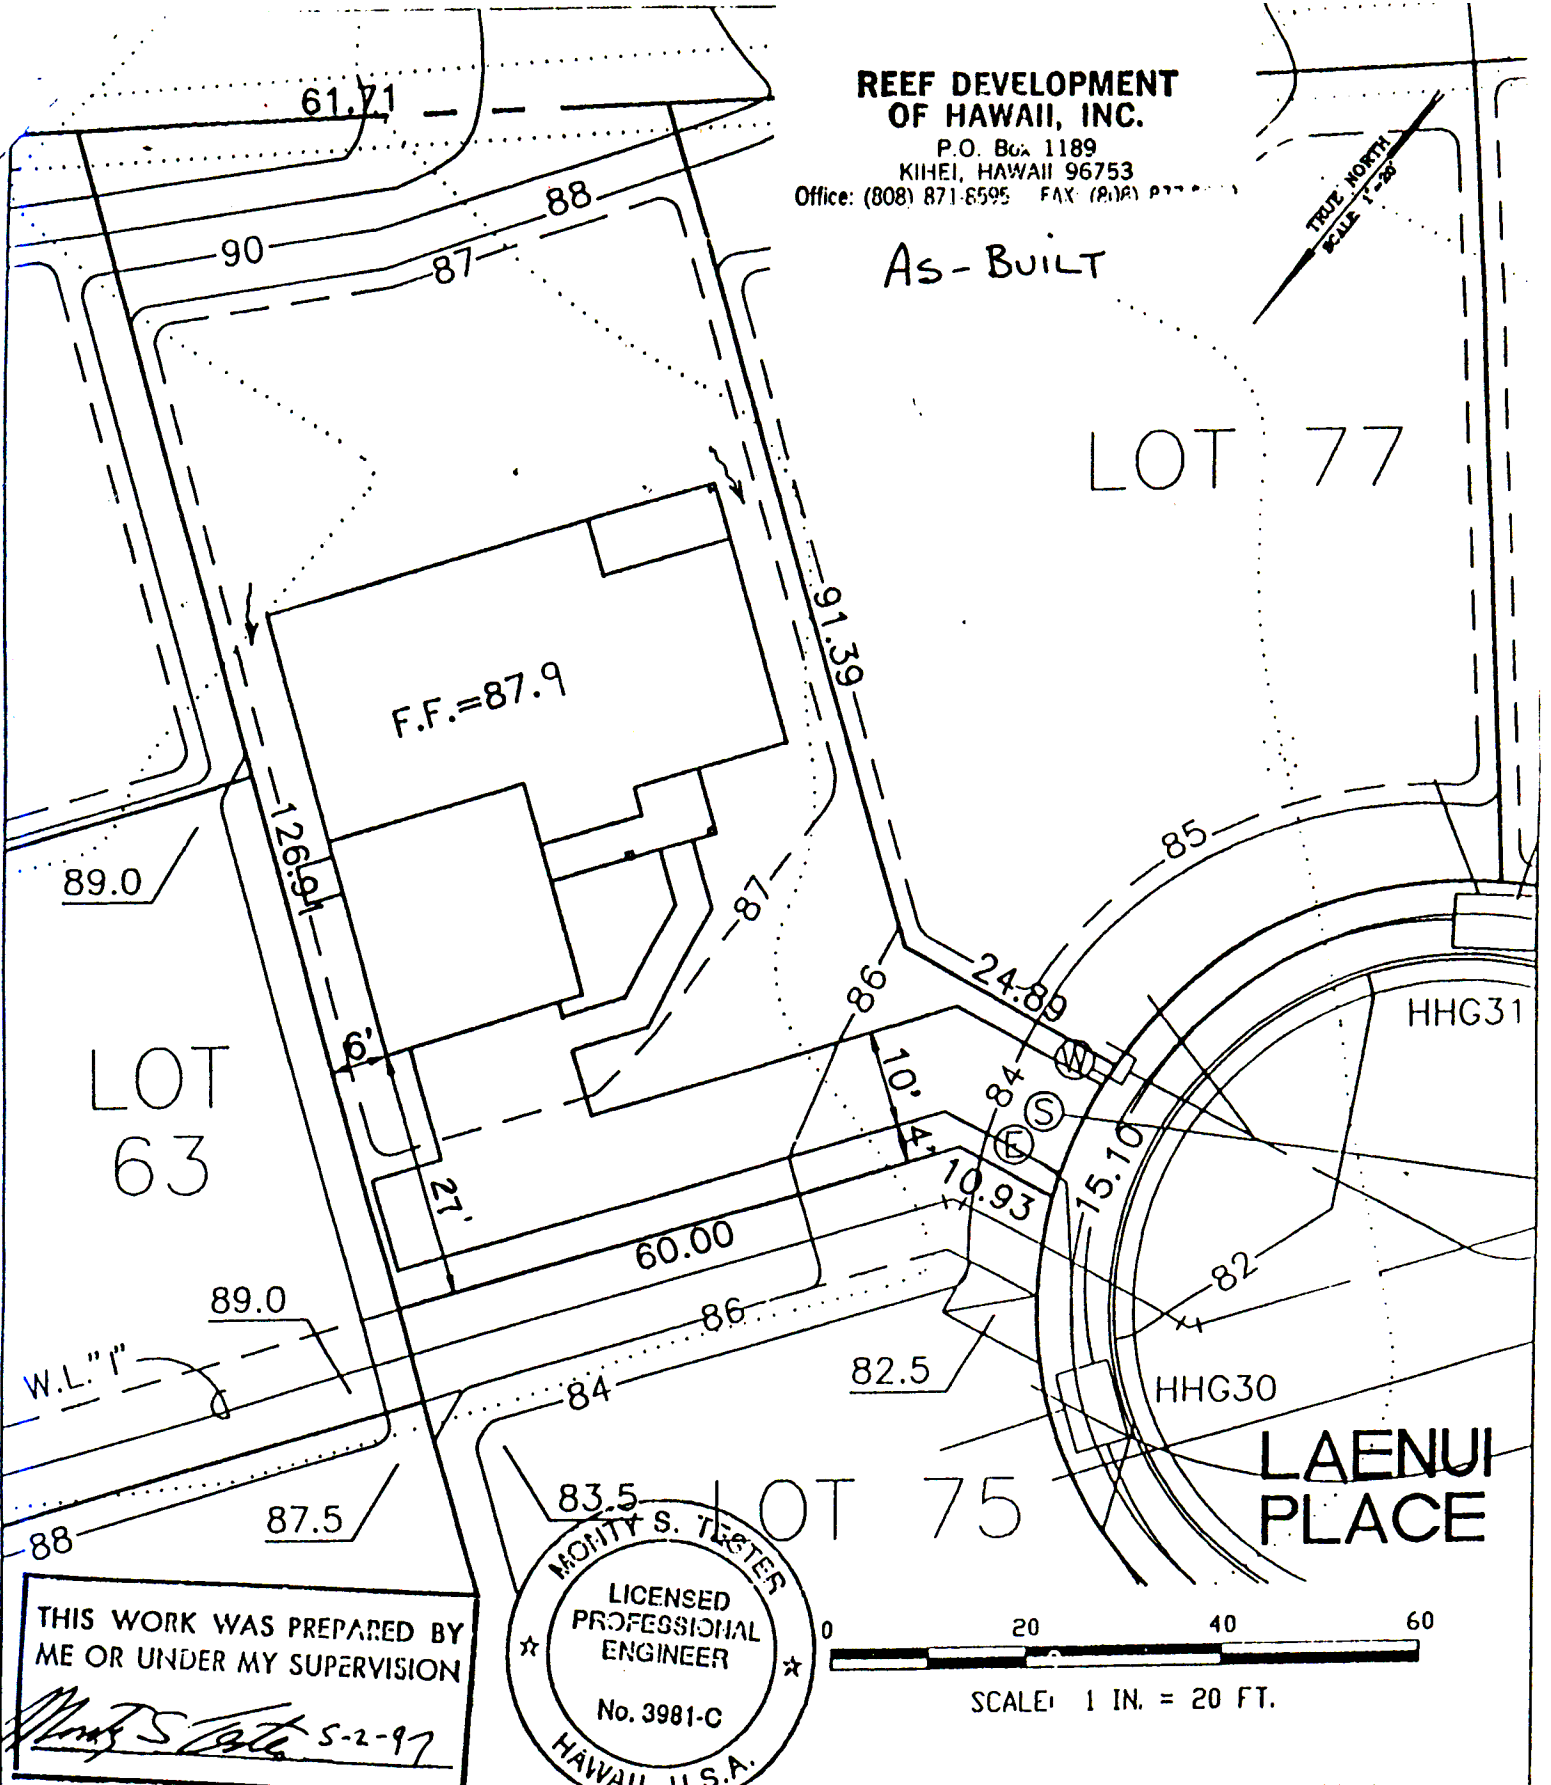


**REEF DEVELOPMENT  
OF HAWAII, INC.**

P.O. Box 1189  
KIHAEI, HAWAII 96753  
Office: (808) 871-8595 FAX: (808) 871-8596

AS-BUILT

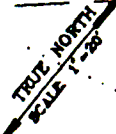


LOT 63


LOT 77

LOT 75

LAENUI PLACE

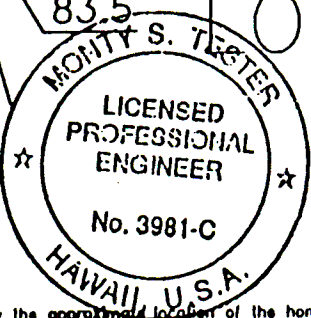

THIS WORK WAS PREPARED BY  
ME OR UNDER MY SUPERVISION  
*Monty S. Teeter* 5-2-97

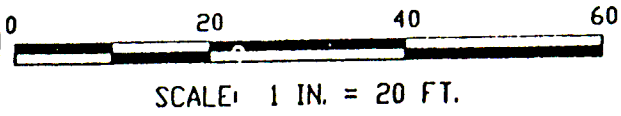

Note: This plot plan is intended to show only the approximate location of the home, utilities, and drainage contours, and should not be used by the buyer for any other purpose. The buyer should independently verify the precise location of utilities and drainage contours before performing any work that may affect the utilities or drainage for this property.

**Plot Plan For Lot: 76**

House Color:	Model No.: 1200
House Trim Color:	File Plan Lot No.:
Roof Color:	T.M.K.:
	Brochure Lot No.: